


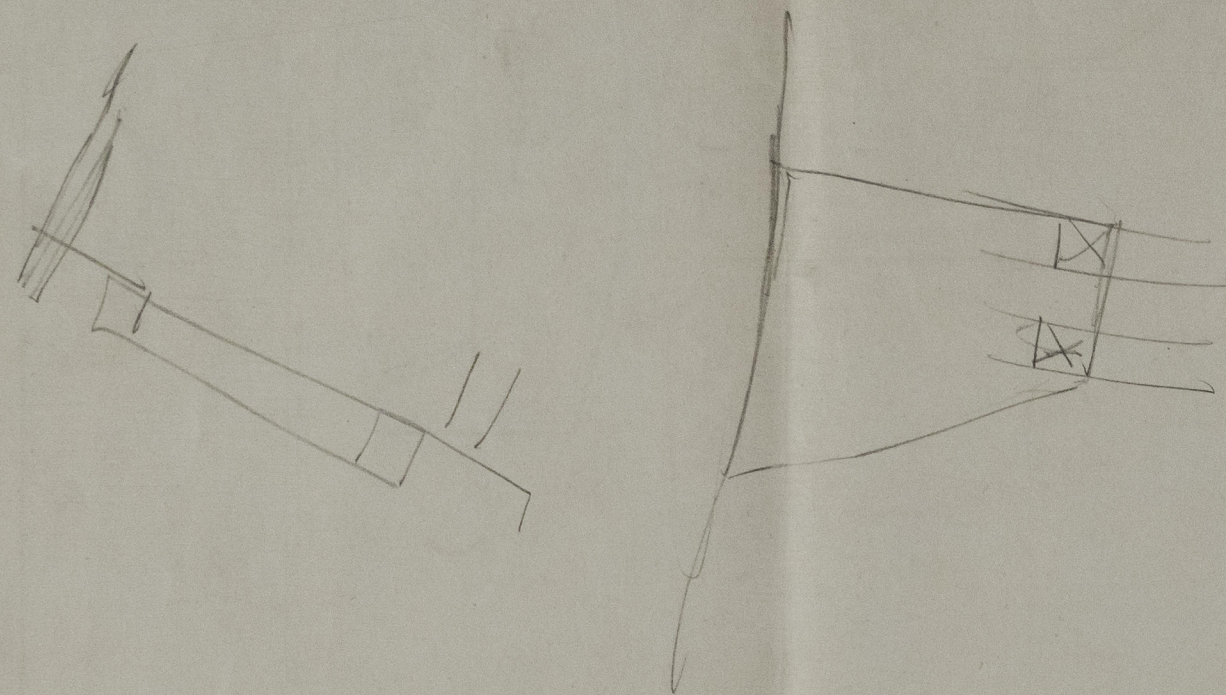

0003



014110 - 014123 - 0003

*§2 Euthalia ex Baddeck (Lower class)*

18 JAN 1948

0003

*General Argt (conversion)*

*§2 EUTHALIA ex BADDECK.*

*Cardiff. S.I. Pl.*

*now*  
*Yousuf Zainal Aliriz*

*Box*



© 2021

Lloyd's Register  
Foundation



© 2021  
Lloyd's Register  
Foundation



Profile Upper Deck

Port Dockyard Sta.

1/2 EETHALIA

ref. 2. 2. 17.

now Yousof Zainal Alirez

014110 - 014123 - 0005



© 2021

Lloyd's Register  
Foundation

Eethalia



Profile & Upper Deck.

S/S "Eftalia"

3 FEB 1947

014110-014123-0005

S.S. "EFTALIA"  
Profile & Upper Deck.

0005




© 2021

Lloyd's Register  
Foundation



S.S. EPTHALIA  
STRUCTURAL COMPENSATIONS DUE TO ALTERATIONS  
SCALE 1/4" = 1' ±

3 FEB 1947

 



H

CONVERSION PROFILE & UPPER DECK

CORK DOCKYARD LTD.

EFTHALIA. EX BADDECK.

29.3.86.

now Yusuf Zainal Alirez

NEW DECK

014110-014123-0002



© 2021

Lloyd's Register  
Foundation



PROFILE & UPPER DECK

EFTHALIA

12 MAR 1946

0002

Bay



© 2021

Lloyd's Register  
Foundation











SCALE  $\frac{1}{4}'' = \text{FOOT}$

12 MAR 1946

Approved  
27-8-46

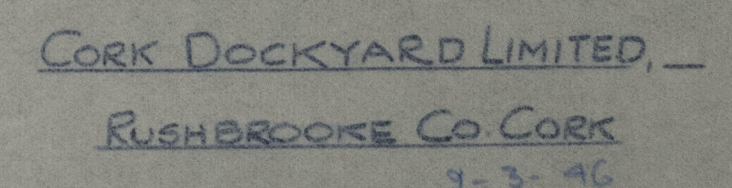



2

Main Deck Arrgt

$\frac{5}{8}$  F<sup>E</sup>NTHALIA ex BADDECK.

Cardiff 8.1.46.

now Yousof Zainal Aliriz

Main Deck (Arrgt)

$\frac{5}{8}$  Enthalia ex Baddecks.

8 JAN 1946

0004


014110-014123-0004

Box

0004





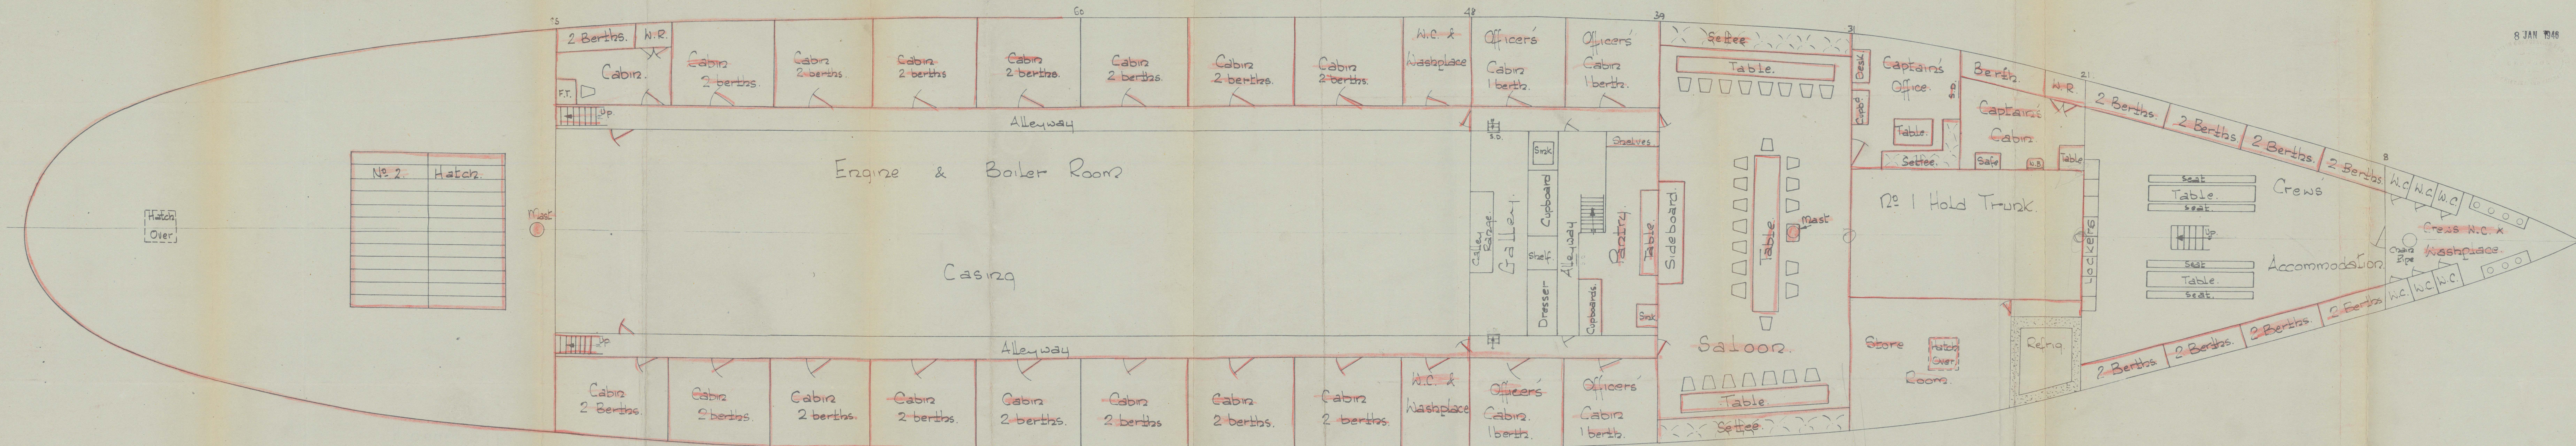

Drawing Office.  
 C. H. Bailey Ltd, Barry.  
 Date: Jan 3rd '46.  
 Fly to Drawing No. 764/2.

Proposed Conversion to s.s. "Euthalia" ex Corvette "Baddeck"  
Plan of Main Deck.  
 Scale:- 1/4" = 1ft.

New work shown in Red.



014110-014123-0001

DECKS

EFTHALIA

12 MAR 1946

0001

§5 EFTHALIA. ex BADDECK.

CORK DRP. Co.

27. 3. 46.

now Yusuf Zainal Abidin

© 2021

Lloyd's Register  
Foundation





# CORVETTE 'ETHALIA' ex H.M.C.S. BADDECK

SCALE - 1/4" = 1 FOOT -

12 MAR 1940

Approved  
27-3-40  
C.B.H.

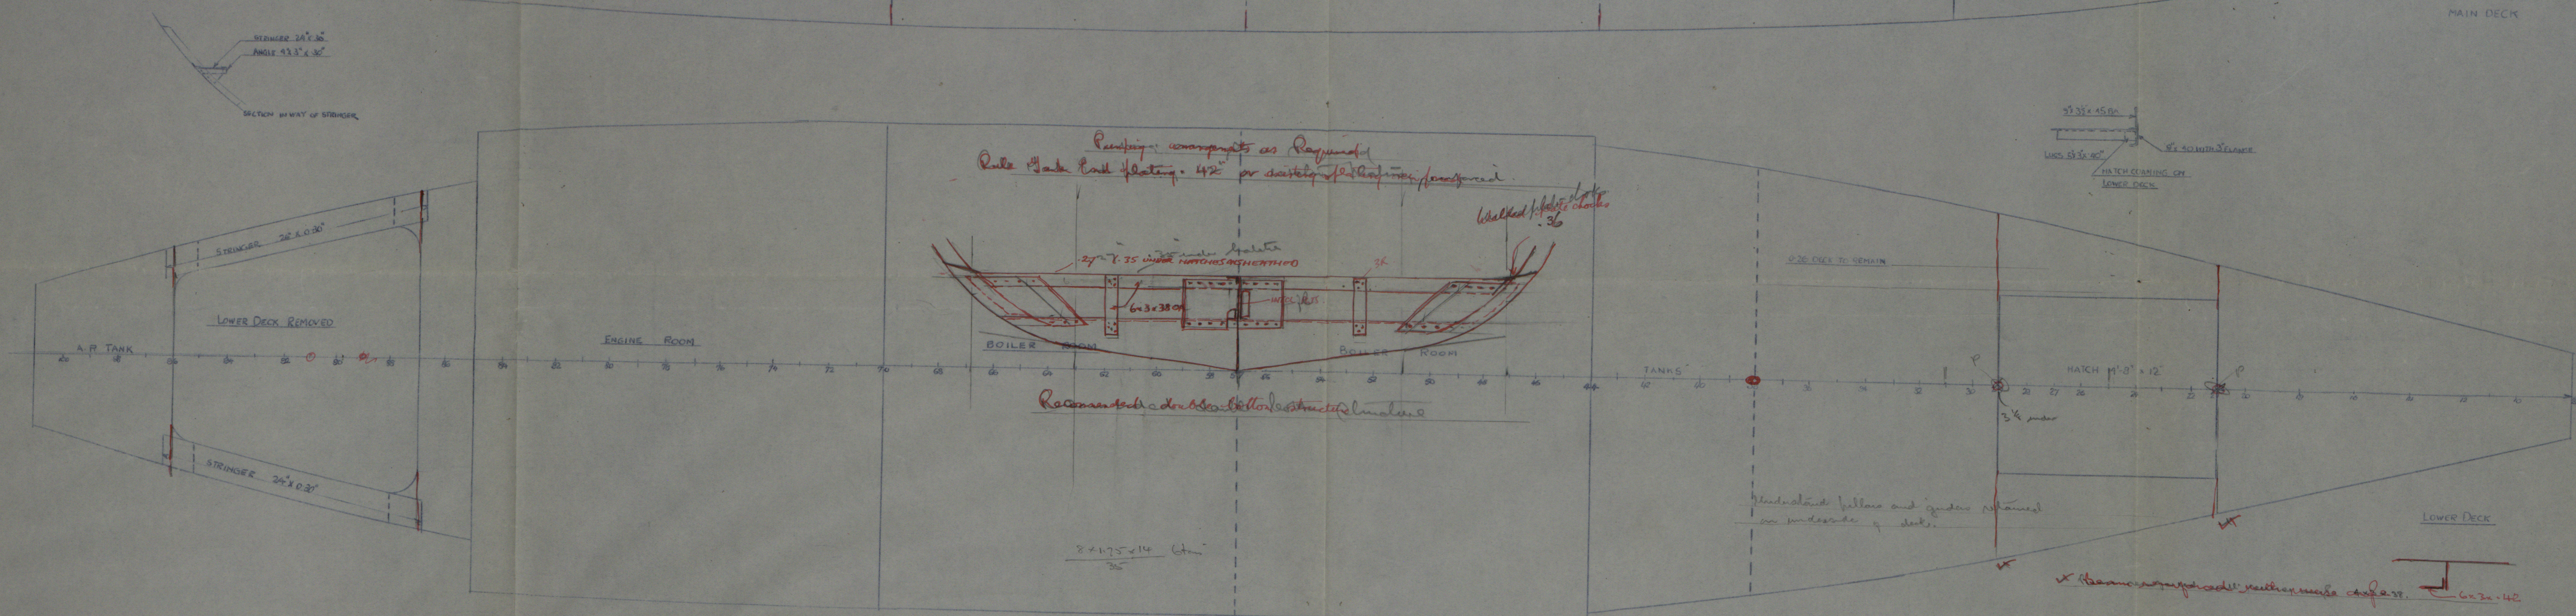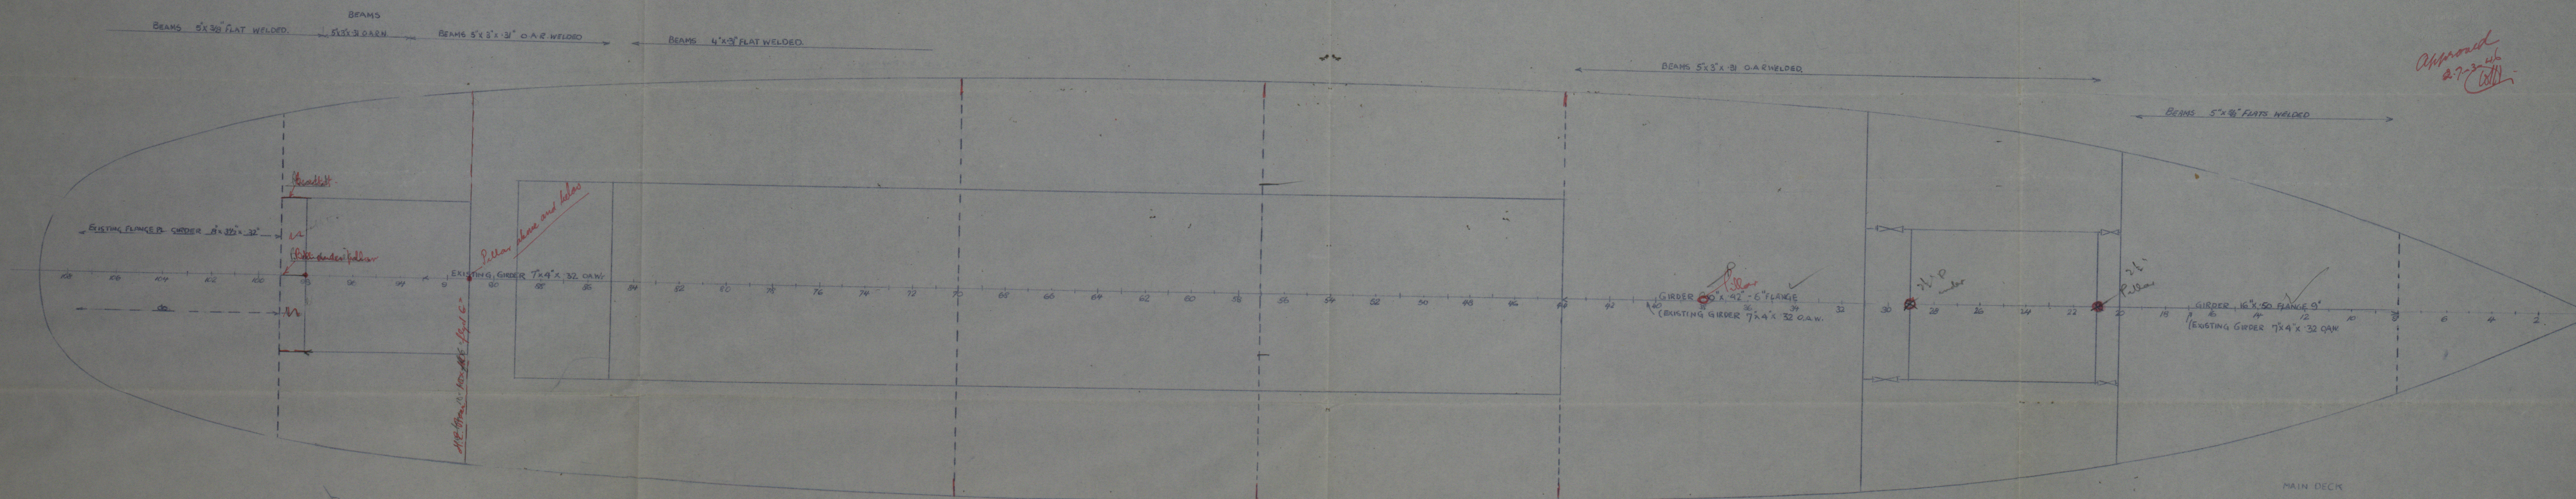



9-3-40